

APPLICANT:

Name: South Ridge Estates Inc.


Address: 40 Chelton Avenue

West Hartford, Conn. 06110


Phone: 203-522-5323.

NOTE:

Reference made to map entitled "Property of South Ridge Estates Abby Road & Nevers Road South Windsor, Conn. 1-15-79 Rev. 6-29-79 Scale: 1" = 40' By Emil W. Lucek Associates

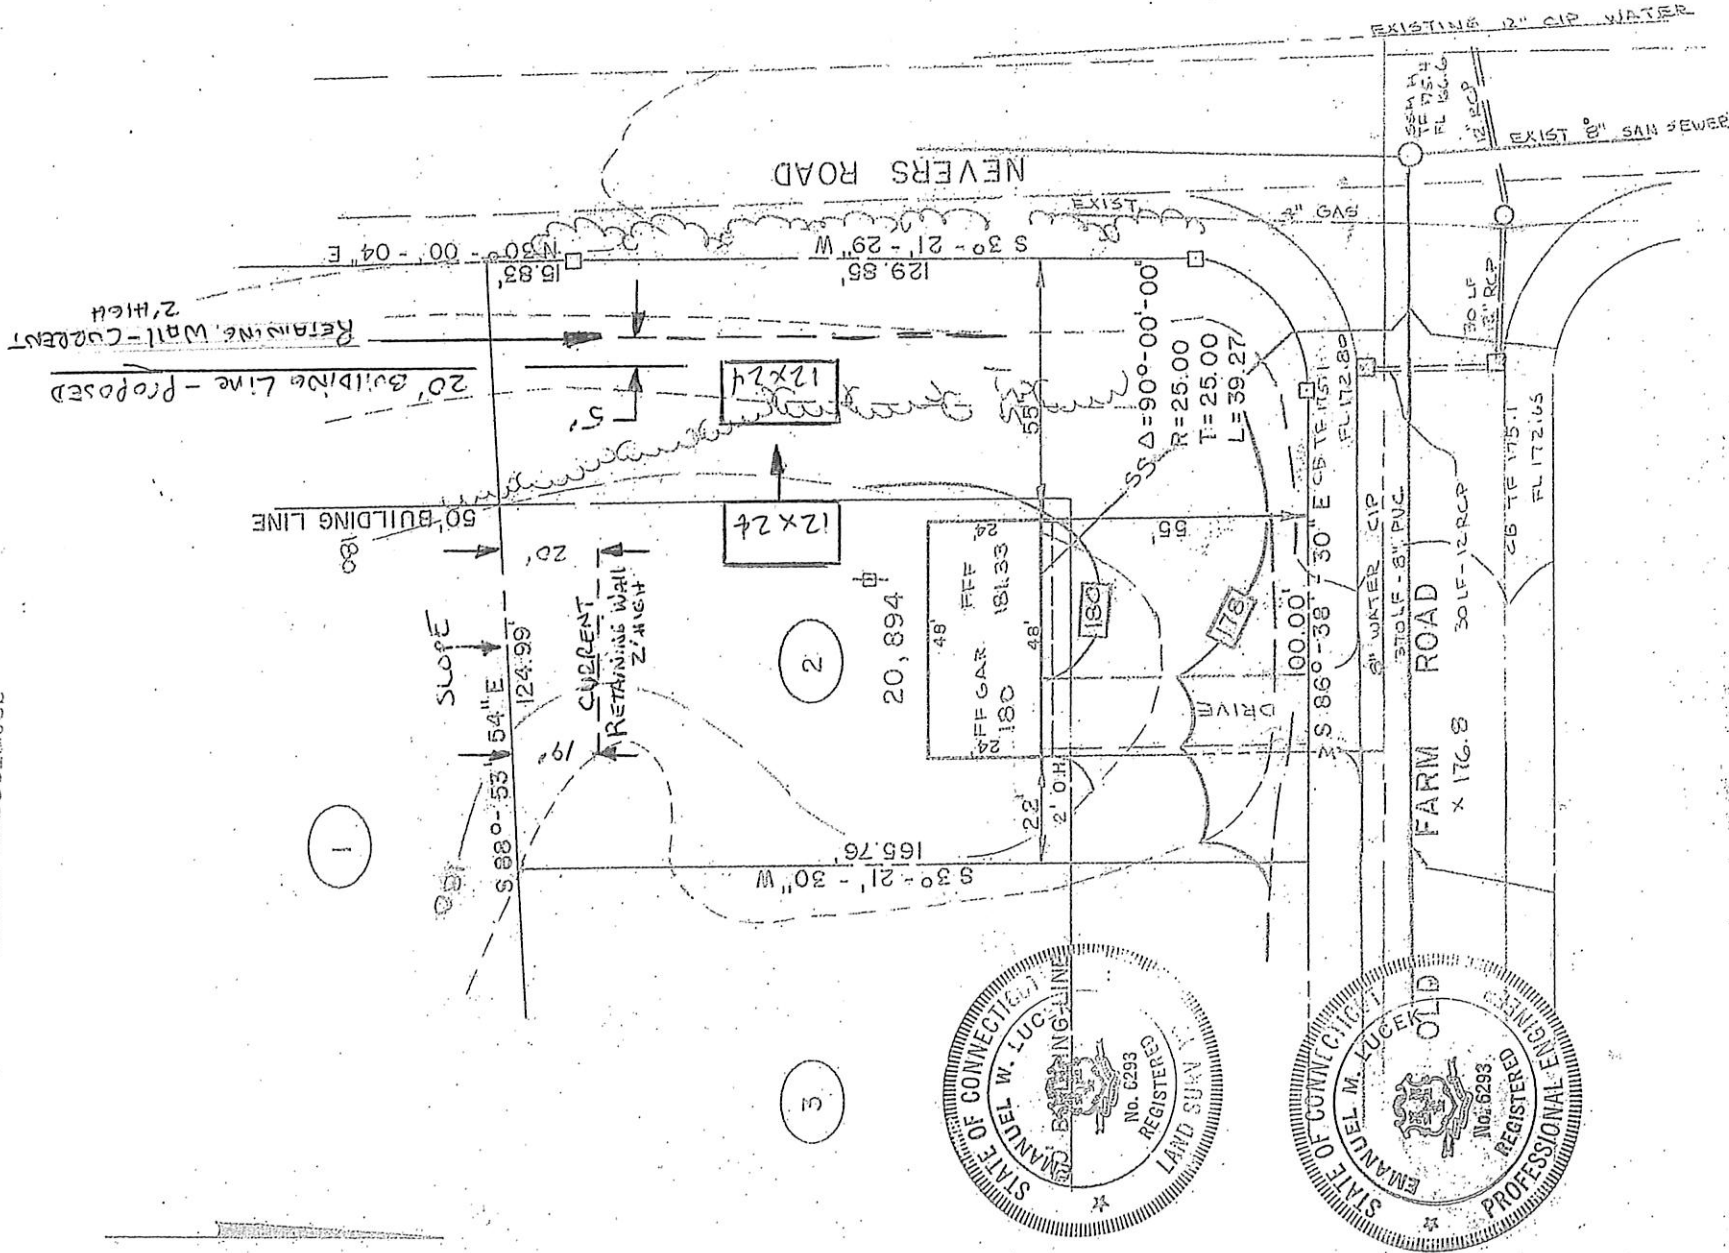

ZONE RR OPEN SPACE SUBDIVISION

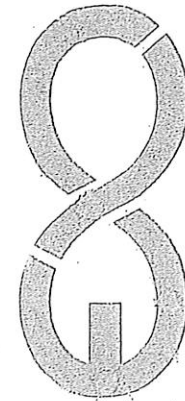

CONSULTING ENGINEERS
5 OAKLAND ROAD
SOUTH WINDSOR, CONN.
203-644-2474

PROPERTY OF SOUTH RIDGE ESTATES

6 OLD FARM ROAD

SOUTH WINDSOR, CONN.

EMIL W. LUCEK ASSOCIATES

NO.	REVISIONS	DATE	SCALE 1" = 40'	DATE 4-10-79
1	AS BUILT	11-8-80		
			DRAWN A.V.H.	CHECKED E.W.L.
			PROJECT 78-68	SHEET

CERTIFIED SUBSTANTIALLY CORRECT - DEGREE OF ACCURACY FOR BUILDING PURPOSES

Emil W. Lucek